



**SNOHOMISH
HEALTH
DISTRICT**

Parcel Tax Account Number (PTA)

00607300000400

Old PTA Number

60730000040005

Property Information

Site Address

16630 FORTY FIVE RD
ARLINGTON, WA 98223-9648

Owner Address

ROSGAARD DAVID J
UNKNOWN
UNKNOWN, WA

Sewer: Yes
Year House Built:
Map Quarter Section: NE

Section: 25
Township: 31
Range: 04

Use Code: 184 Septic System
Plat Name: VISTA VIEW
Legal Description: VISTA VIEW BLK 000 D-00 LOT 1 AS DESC IN SP 92(3-85) AF8602100113 & BEING PTN LOT 4 REFER TO 6073-000-004-0203 FOR MH ONLY

Drainfield Supplemental Information


System Type: GRAVITY
Year Installed: 1986
AsBuilt Sent: 4/16/2004

Latitude:
Longitude:
Last Update: 7/14/2015

Comments:

CASCADE
SURVEYING ENGINEERING, INC.
102 East Division
ARLINGTON, WASHINGTON 98223
435-5551 652-7572

JOB POESCHEL & SCHULTZ
SHEET NO. 4788 OF _____
CALCULATED BY C.A. DATE 10-30-86
CHECKED BY _____ DATE _____
SCALE 1"=40'

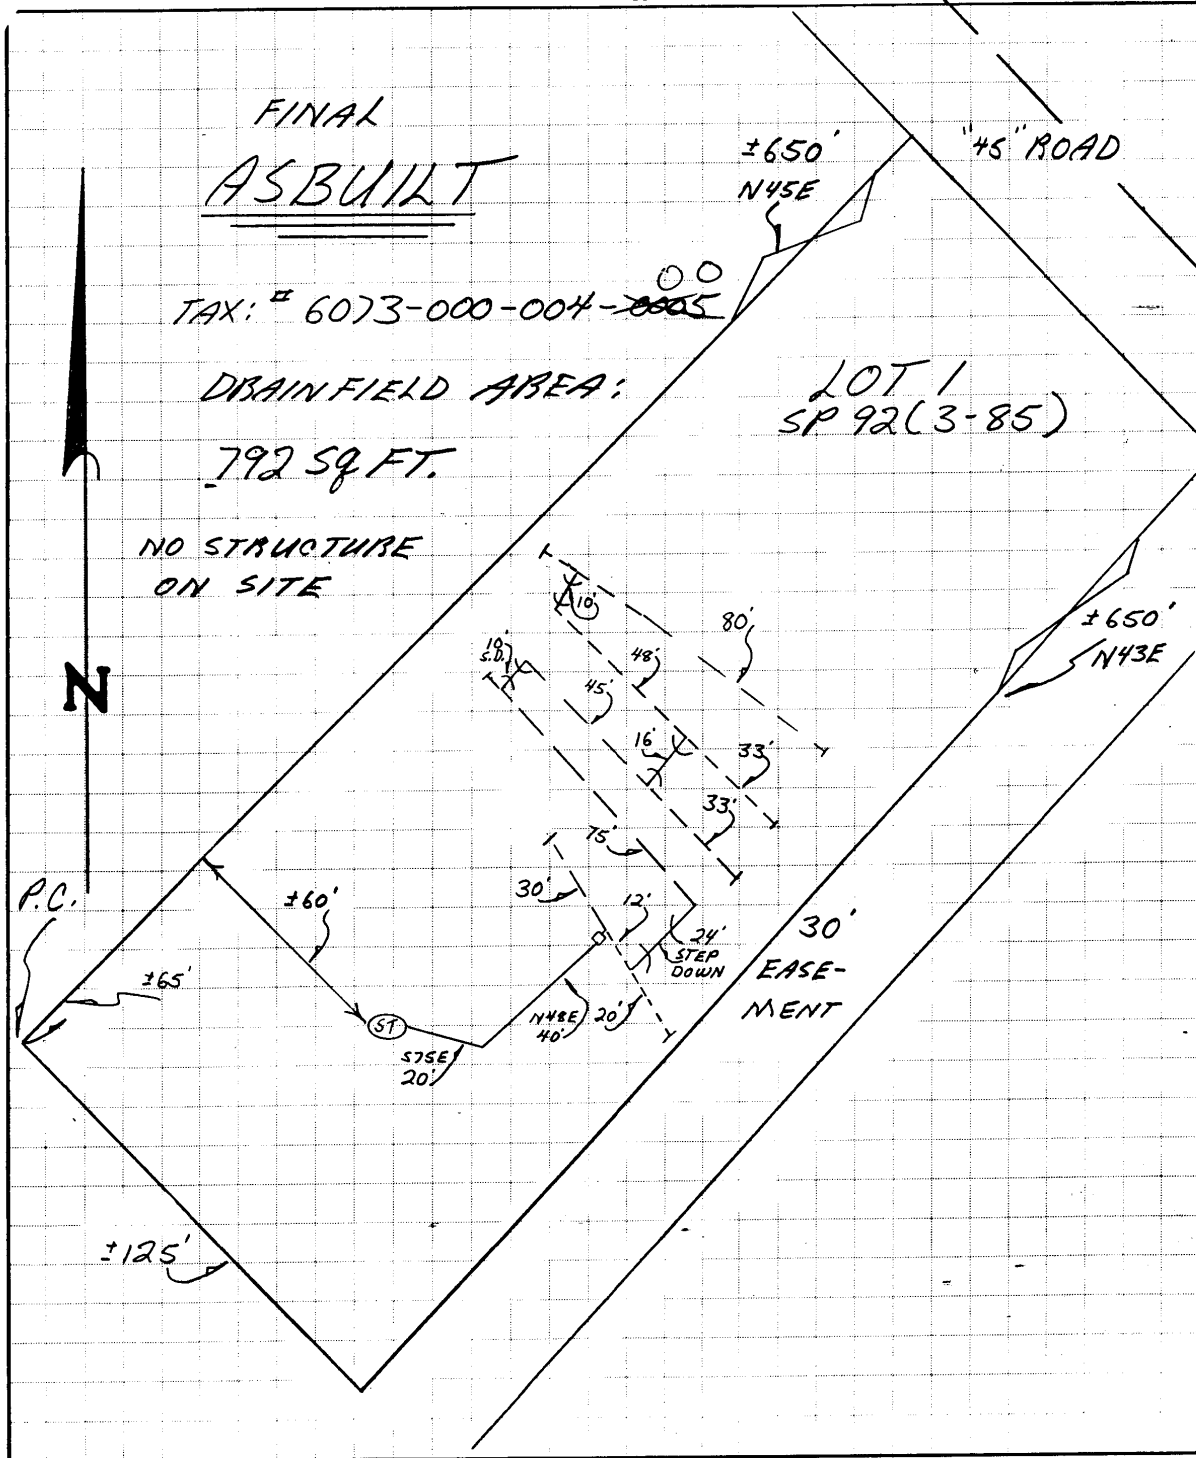

SNOHOMISH HEALTH DISTRICT

Environmental Health Division
Courthouse, Everett, Washington 98201

Permit No.: 1495-86

SEPTIC TANK INSTALLATION PLAN

Submit in Triplicate

Acct. No. 6073-000-004-~~0005~~⁰⁰

Owner Poeschel & Schultz Address 19203 Hwy 99 Arlington, WA Phone 652-8900

ADDRESS OF PROPERTY approximately 16700-45 Road, Lakewood, WA 98259
16630 45 ROAD, ARLINGTON


Legal Description Section 25, Township 31, Range 4

Short plat #92 (3-85) Lot 1

Designer Jim K. Sutton Address PO Bx 326 ARLINGTON, WA Phone 435-5551

Installer Poeschel & Schultz Address 19203 Hwy 99 Arlington WA Phone 652-8900

I hereby certify the accompanying drawing is an accurate representation of the system installed at the listed address. I also certify all recommendations and restrictions (concerning plumbing stub elevations, maintenance of grades, fills, surface drains, etc.) listed by me on my sewage disposal system permit application dated 8/15/86 have been complied with.

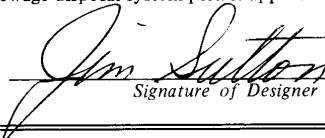
Signature of Designer

October 30, 1986
Date

See Nov, 17 Revision

TO BE FILLED IN BY HEALTH DEPARTMENT ONLY

Accepted X Date 12/8/86

Not Accepted _____ Date _____

Signature of Sanitarian Mike Poner

Remarks: _____

ATTENTION HOME OWNER:

Your septic tank has limitations! It was designed and installed to care for an average-size family. Over-loading the septic tank or disturbance of the drain field may seriously impair satisfactory operation. Points to remember:

1. Have your tank checked periodically to see if pumping is necessary (2½-3 years).
2. Do not channel ground water, surface water, footing drains or downspouts into the tank or drainfield.
3. Do not excavate, fill, place a structure, driveway or patio in, on, or over the drainfield.
4. Limit toilet fixture disposal to sanitary wastes and toilet tissue.
5. Detergents and bleaches used in normal household quantities will not harm the action of the septic tank and disposal field.

MD

SNOHOMISH HEALTH DISTRICT

Environmental Health Division
Courthouse, Everett, WA 98201 • Phone: 259-555-1111



6073-000-004-0005
(PROPERTY TAX ACCOUNT NUMBER)

APPLICATION FOR AN ONSITE SEWAGE DISPOSAL PERMIT

(Submit 3 Copies)

Applicant Poeschel and Schultz Phone 652-8900

Address 19203 Old 99 Arlington, WA 98223

For installation at Approximately 16700 45 Road Lakewood, WA ARL

Sec. 25 Twp. 31 Rg. 4 Legal desc. _____

Short Plat/Block/Section SP 92(3-85) Lot 1; Plat _____ Lot _____ Blk. _____

Type of Building: New Existing _____ SFR Duplex _____ No. Bdrms. 3 Other _____

Water Supply: Public Name Lakewood Water Ltr. of Availability _____

Private _____ Source _____ Protective Covenants _____

Attach a detail drawing to scale of the onsite system indicating: soil log holes, drainfield lines, 100% reserve area, contours, elevations, bodies of water, property lines, house location, banks, excavations, easements, north, and any well within 100 feet.

SOIL LOG 1. 0-27" brown gravelly sandy loam; 27-30" tan gravelly sandy loam; 30-38" tan/gray mottled roots to 27" hard pan at 38"

SOIL LOG 2. 0-26" brown gravelly sandy loam; 26-36" tan/gray mottled hard pan at 36"

SOIL LOG 3. 0-30" brown gravelly sandy loam; 30-38" tan gravelly sandy loam; 38-48" tan/gray mottled

SOIL LOG 4. 0-30" brown gravelly loamy sand; 30-45" tan/gray fine medium loamy sand hard pan at 45"

SCS CLASSIFICATION Alderwood #1 SOIL TYPE #4 APPLICATION RATE .6 gal/sq. ft./day

DEPTH TO HIGHEST SEASONAL GROUNDWATER 27 ins. OBSERVED _____ ESTIMATED DATE 8 / 15 / 86

COVER SOIL REQ'D. (depth and amount) 6"-12" / 100 cu. yd. variable trench depth

SEPTIC TANK SIZE 1000 gallons TRENCH: SQ. FT. 750 WIDTH 24 ins. DEPTH 12" - 18" ins.

Signature of Designer Jim Sutton Jim K. Sutton Date 8 / 15 / 86

License No. 17613 Phone 435-5551 Cascade

DO NOT WRITE BELOW THIS LINE

Permit Denied _____ Date _____ Sanitarian _____

Well Setback Compliance: Yes _____ No _____

9/5/86 Pending: (date) Does not appear to be sufficient area of marginal soils to maintain a 100% reserve area. Recommend additional investigation to locate a spare drainfield area. WVD.

APPROVED Date 10/1/86 SANITARIAN WVD

PERMIT ISSUED: (date) 10/9/86 BY DC PERMIT NO. 1495-86

CALLED FOR INSPECTION: (date) 10/23/86 BY Cascade INSTALLER P&S.

A copy of the Health District's Appeal Procedure will be furnished upon request.

*22409
41029*